

5/14

DART AEROSPACE LTD	Work Order:	22736
Description: Basket Rib 04.05.06 <i>by</i> 04.05.06 <i>CP</i>	Part Number:	D3166-1
Dwg: D3166 Rev. A1	Qty:	10
Page 1 of 1		

Step	Location	Procedure	By	Date	Qty
1	DC	Issue Traveller	<i>HA</i>	05.03.17	10
2	LB	Cut 3/4" x 3/4" square tubing 60.00" long. Material: 304/316 SS tube 0.003" wall Batch <i>B12213</i> <i>0.005"</i>	<i>DP</i>	05/4/5	10
3	LB	Form D3166-1 Basket Hoop as per Dwg D3166 using Bending program 350 BASB. and Folio FT004	<i>DP</i>	05/4/11	10
4	QC6	Inspect Basket Hoop dimensions with template D3166-1-T1 (DT8302)	<i>HA</i>	05/04/12	10
5	LB	Identify and Stock LB Cell	<i>DP</i>	05/4/12	10
6	AC	Cost / part <i>12.47</i>	<i>Soc</i>	05.04.14	10
7	DC	Close W/O <i>13.47</i> Inspect Level 21	<i>HA</i>	05.04.15	10

Rev	Date	Change	Revised By	Approved
A	02.08.23	New issue	<i>KJ RF</i>	<i>[Signature]</i>

RELEASED
02/08/27 RF

W/O:		WORK ORDER CHANGES					
DATE	STEP	PROCEDURE CHANGE	By	Date	Qty	Approval Mfg / Design Mgr	Approval QC Inspector

NCR:		WORK ORDER NON-CONFORMANCE (NCR)						
DATE	STEP	Description of NC Section A	Corrective Action Section B			Verification Section C	Approval Design Mgr	Approval QC Inspector
			Initial Design Mgr	Action Description Design Mgr	Sign & Date			

Part No: _____ PAR #: _____ Fault Category: _____ NCR: Yes No DQA: _____ Date: _____


NOTE: Date & initial all entries

QA: N/C Closed: _____ Date: _____



DESIGN #	DRAWN BY CP	DART AEROSPACE LTD HAWKESBURY, ONTARIO, CANADA	
CHECKED #	APPROVED #	DRAWING NO. D3166	REV. A SHEET 1 OF 1
DATE 02.07.10		TITLE BASKET HOOP	SCALE NTS
A	02.07.10	NEW ISSUE	
A1	04.04.08	38+/-1 was 36.0	


RELEASED
02.08.06

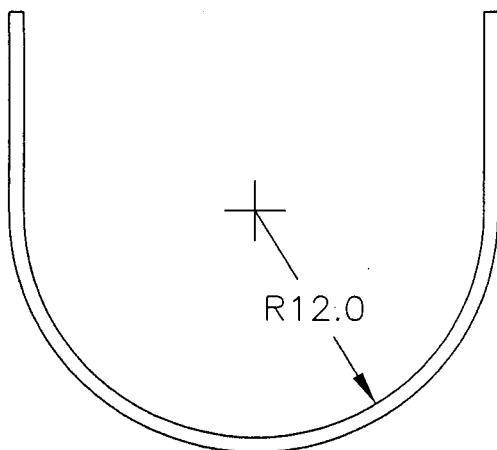

10.6 (REF, NEED 8.0 MIN)

D3166-1 BASKET HOOP

- 1) MATERIAL: AISI 304/316 SS SQUARE TUBING,
0.75" x 0.75" x 0.063 WALL, 60.00" LONG
(REF DART SPEC. M304TS0.750W.063)
- 2) FINISH: NONE
- 3) TOLERANCES ARE PER DART QSI 018 UNLESS
OTHERWISE NOTED

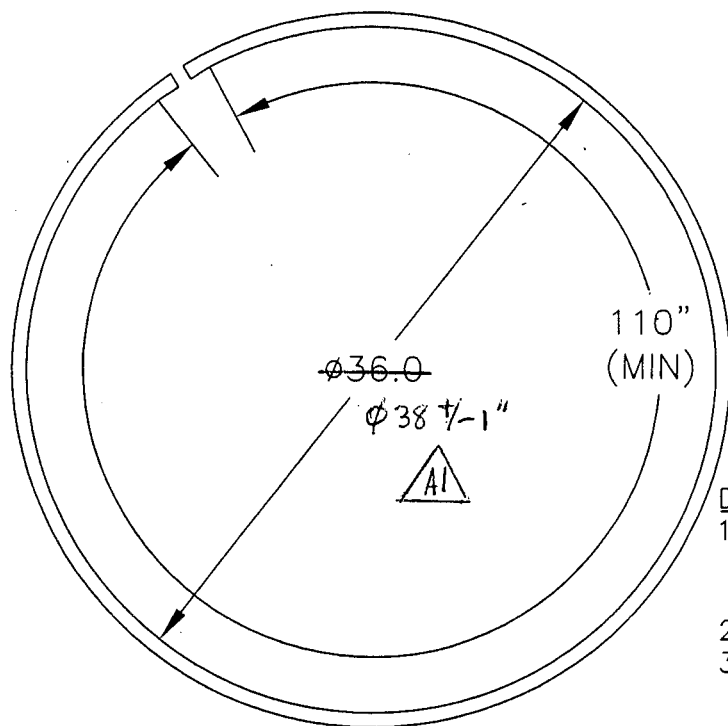

SHOP COPY
RETURN TO
ENGINEERING
UNCONTROLLED COPY
SUBJECT TO AMENDMENT
WITHOUT NOTICE
WORK ORDER
NO. 22736

D3166-3 BASKET HOOP

- 1) MATERIAL: AISI 304/316 SS SQUARE TUBING,
0.75" x 0.75" x 0.063 WALL, 120.00" LONG
(REF DART SPEC. M304TS0.750W.063)
- 2) FINISH: NONE
- 3) TOLERANCES ARE PER DART QSI 018 UNLESS
OTHERWISE NOTED

Copyright © 2002 by DART AEROSPACE LTD

THIS DOCUMENT IS PRIVATE AND CONFIDENTIAL AND IS SUPPLIED ON THE EXPRESS CONDITION THAT IT IS NOT TO BE USED FOR ANY PURPOSE OR COPIED OR COMMUNICATED TO ANY OTHER PERSON WITHOUT WRITTEN PERMISSION FROM DART AEROSPACE LTD.

Job Costing Report

Dart Aerospace Ltd.
Hawkesbury

Mar 16, 2005
02:16 pm

Work Order No : 0022736
Project Name : D3166-1
Project For : WK514
Work Order Type : Main
Main WO Number :
House Part Number : D3166-1
Description : Basket Hoop
Manufactured : Yes
Amount Req'd : 10
Amount Done : 0
Start Date : 03-16-05
Est Finish Date : 04-10-05
Act Finish Date :
Drawings Req'd : No
Ok for Approval :
Approval Rec'd :

Department Code:
Burden Flags : NNNNNNNN
WO Status : Open
Invoice State : Not Invoiced
Invoice Date :
Invoice Number :
Invoice Amount : 0.00
Order Entry No :
OE Value : 0.00
Est Mark Up : 0.000%
Actual Mark Up : 0.000%
\$0 Posted to Finished Goods

	Estimated	Actual	Var. %	Posted	To Post
Material Cost :	0.00	0.00	0.00	0.00	0.00
Engineering Hours :	0.00	0.00	0.00		
Engineering Cost :	0.00	0.00	0.00	0.00	0.00
Production Hours :	0.00	0.00	0.00		
Production Cost :	0.00	0.00	0.00	0.00	0.00
Packaging Hours :	0.00	0.00	0.00		
Packaging Cost :	0.00	0.00	0.00	0.00	0.00
OverHead Hours :	0.00	0.00	0.00		
OverHead Cost :	0.00	0.00	0.00	0.00	0.00
CNC Hours :	0.00	0.00	0.00		
CNC :	0.00	0.00	0.00	0.00	0.00
Misc. Hours :	0.00	0.00	0.00		
Misc. :	0.00	0.00	0.00	0.00	0.00
Burden :	0.00	0.00	0.00		
Total Cost :	0.00	0.00	0.00		
Mark up :	0.000	0.000			
Selling Cost :	0.00	0.00			

	Estimated	Actual
Labour Hrs/Amount Done :	0.00	0.00
Profits/(Loss) :	0.00	0.00